THIS PLAN FOR REFERENCE ONLY
NO REPRESENTATION OR WARRANTY IS MADE AS TO LOCATION OF BOUNDRIES OR OTHER POINTS OF REFERENCE.

THE AUDUBON SOCIETY OF NEW HAMPSHIRE
1651/137 (3) 11/17/62

STA. 522+80 = R.R. STA. 2355+00.81

N 89 1/2° E

THE AUDUBON SOCIETY OF N.H.
1723/180 (1) 6/29/64

STR # 7

FAITH N. YORK
WILL # 43880 4/12/60

EDGERLY

THE AUDUBON SOCIETY OF N.H.
1749/299 (4) 8/5/64

HAMPTON FALLS, N.H.
HAMPTON, N.H.

NOTE: BRIDGE
ADDITIONAL T

CREEK

STR # 8

SOCIETY FOR THE PROTECTION OF N.H. FORESTS
1945/197 (2) 11/7/68
800± ⏍

CREEK

3139

PROPOSED R.O.W

℄ TRACKS

19.32'

107'±

EXIST. B&M R.R. R.O.W.

℄ PROPOSED R.O.W.

75.00'

32'±

N 17°-41'-07" E

613'±

331'±
332'±

47'±

282'±
278'±

46'±

38'±

301'±

9'±

305'±

37'±

46'±

342'±
342'±

22'±

45'±

76'±

230'±
320'±

50'±

141'±
135'±

47'±
159'±

84'±

82'±

THE AUDUBON SOCIETY OF NEW HAMPSHIRE
1749/299 (3) 8/5/64
1651/137 (3) 11/17/62

MILE 1
MILE 2

MATCH LINE

0.3± ACRE
THE AUDUBON SOCIETY OF N.H.
1723/180 (2) 6/29/64

S 88 1/2° W

0.3± ACRE
YORK

S 87 1/2° W

CARLETON S. EDGERLY
PROBATE #35461 7/26/48
(DESC. 453/69 (5) 9/28/1874)

0.3± ACRE

N 82° W

CREEK

0.4± ACRE
THE AUDUBON SOCIETY OF N.H.
1749/299 (4) 8/5/64

N 82° W

23'±

N 11°-29'-75" E
75'±
FORMERLY
HARRY T. PHILBRICK
805/203 8/23/29
SEE EAA 11380
EAA 11380

STR #9

S 81 1/2° W

CREEK

0.3± ACRE

0.2
ROBERT
PER
1306/289

HAMPTON FALLS, N.H.

TOWN LINE (APPROXIMATE)

115' TAN SINGLE POLE

115' TAN SINGLE POLE

NOTE:
CONTINUOUS COUNTERPOISE ALONG R.R. R.O.W. IS LOCATED APPROXIMATELY 10 FEET LEFT OF THE CENTERLINE EXCEPT AS SPECIFICALLY NOTED ON PLAN AND BREAKS ONLY AT WATER CROSSINGS WHERE BRIDGES EXIST.

LEGEND
EXISTING ACCESS
NEW ACCESS ROAD
COUNTERPOISE

6/1/81	DGP	DJH	DJH
11/16/79	W.T.W.	H.R.M.	J.E.H.
8/30/78	B.J.	W.S.	T.M.
8/25/78	B.J.	W.W.	T.M.
DATE	DRWN.	CHKD.	APPR.
REVISIONS			

F. PALM
B.E. JONES
W.S. SEARS
8/15/78

PLAN
DRAWN
PLOTTED
FIELD BOOK
No.
AS-BUILT DIMENSIONS
RT. OF WAY CHECKED

HAMPTON, N.H.

THIS PLAN FOR RE
NO REPRESENTATION OR
MADE AS TO LOCATION
OR OTHER POINTS OF RE

NOTE: BRIDGE STRINGERS FOR ADDITIONAL TRACKS ARE IN PLACE.

HAMPTON FALLS, N.H.
HAMPTON, N.H

THE AUDUBON SOCIETY OF N.H.
1749/299(4) 8/5/64

SOCIETY FOR THE PROTECTION OF N.H. FORESTS
1945/197(2) 11/7/68
800± ⏢

CREEK

3139'±

STR. #10

NEW ENGLAND TEL. & TEL. CO.
720/461 1918

NOW PUBLIC SERVICE CO. OF N.H.
DHA 6716
FORMERLY
RAYMOND O. (DECEASED) & GERTRUDE C. HOBBS
1529/469 11/20/59
0.3± ACRE

380'±
16'±
16'±
1906'±

TAYLOR

B&M R.R.
577/72 7/30/1900

STR. #12

BRIDGE

℄ PROPOSED R.O.W.
℄ TRACKS

N 17°-41'-07" E 6530.00'

S 17°-41'-07" W 6529.24'

22'±
76'±
45'±
46'±
342'±
342'±
230'±
320'±
50'±
141'±
135'±
47'±
159'±
84'±
82'±
1098'±
847'±
45'±
360'±
412'±
73'±
300'±
260'±
46'±
N 17°-4
1104'±
1069'±

N82°W
N82°W
S81½°W

CREEK
CREEK

0.3± ACRE
0.4± ACRE
THE AUDUBON SOCIETY OF N.H.
1749/299(4) 8/5/64

HARRY T. PHILBRICK
805/203 8/23/29
SEE EAA 11380
EAA 11380

STR #9

0.3± ACRE

1.1± ACRES
CARL E. NELSON
805/322 4/29/30
(ALVAH H. DOW III)
2267/695(4) 4/24/76

0.2± ACRE
ROBERT G & LOIS B. PERFECT
1306/289(4) 1/22/54

0.4± ACRE

HOBBS

B&M R.R.
577/72 7/30/1900

RIVER

B&M
577/7
7/30/19

STR. #11

DO NOT DISTURB VEGETATION ON R.R. BANKING. DO NOT DISTURB PLANTS AND GRASSES WITHIN THE MARSH.

0.3± ACRE
EDGERLY
7/26/48

NOTE:

TINUOUS COUNTERPOISE ALONG R.R.
W. IS LOCATED APPROXIMATELY 10 FEET
T OF THE CENTERLINE EXCEPT AS
ECIFICALLY NOTED ON PLAN AND
EAKS ONLY AT WATER CROSSINGS
HERE BRIDGES EXIST.

LEGEND

EXISTING ACCESS ROADS ——
NEW ACCESS ROAD - - - -
COUNTERPOISE ——

115' TAN SINGLE POLE
115' TAN SINGLE POLE
115' TAN SINGLE POLE

THOMAS F. MORAN INC
55 South River Road (Rt. 3)
Bedford, N.H. 03102
surveyors
civil engineers
land planners
[illegible] Nashua Street
Milford, N.H. 03055

THIS PLAN FOR
NO REPRESENTATIO
MADE AS TO LOCAT
OR OTHER POINT

THIS PLAN FOR REFERENCE ONLY
NO REPRESENTATION OR WARRANTY IS MADE AS TO LOCATION OF BOUNDRIES OR OTHER POINTS OF REFERENCE.

HAMPTON, N.H.

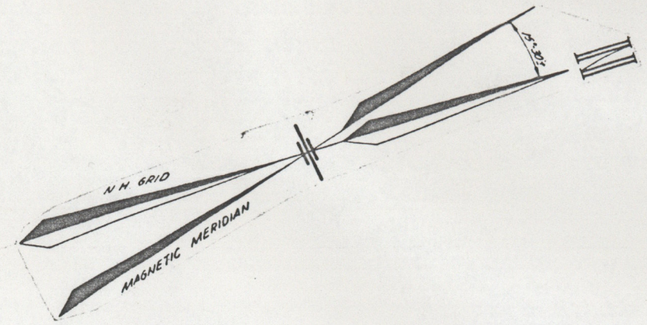

NOW PUBLIC SERVICE CO. OF N.H.
DHA 676
FORMERLY
RAYMOND O. (DECEASED) & GERTRUDE C. HOBBS
1529/469 11/20/59
0.3± ACRE
380'±
16'±
16'±
1906'±

NEW ENGLAND TEL. & TEL. CO.
720/461 1918

TAYLOR

B&M R.R.
577/72 7/30/1900

STR. #12

BRIDGE

P.I. STA. 103+80
STR # 13

EXISTING B&M R.R. R.O.W

PROPOSED R.O.W.

℄ R.R. TRACKS
19.32' ℄ PROPOSED R.O.W.

N17°-41'-07"E
1104'±
1069'±

N18°-13'-19"E
820.00'
595'±
627'±
75.00'
74'±

47'±
362'±
367'±
48'±
37'±

S18°-13'-19"W
820.00'

S61°W

0.7± ACRE
DHF 231
KENRICK M. NORTON & NELLIE J. COLBY
PROB. # 38509 3/1/53
(DESC. 637/224 (1) 8/25/1893)

MILE 2
MILE 3

N53°12'W

STA. 104+00

HOBBS

RIVER

B&M R.R.
577/72 7/30/1900

B&M R.R.
577/72
7/30/1900

B&M R.R.
573/427 7/2/1900

0.4± ACRE

0.4± ACRE

STR. #11

RB VEGETATION ON
DO NOT DISTURB PLANTS
S WITHIN THE MARSH.

THOMAS F. MORAN INC.
surveyors
civil engineers
land planners
th River Road (Rt. 3)
ord, N.H. 03102
Milford, N.H. 03055

13 TAN SINGLE POLE

THIS PLAN FOR REFERENCE ONLY.
NO REPRESENTATION OR WARRANTY IS MADE AS TO LOCATION OF BOUNDARIES OR OTHER POINTS OF REFERENCE.

SEABROOK TO NEWINGTON

345 KV. TRANSMISSION LINE

MILE # 2

PUBLIC SERVICE CO. OF NEW HAMPSHIRE
ENGINEERING DEPARTMENT
SCALE VERT. 1"= 20' HOR. 1"= 200' DATE 3/15/78

LINE # 369

THIS PLAN FOR REFERENCE ONLY
NO REPRESENTATION OR WARRANTY IS MADE AS TO LOCATION OF BOUNDRIES OR OTHER POINTS OF REFERENCE.

EXISTING B&M. R.R. R.O.W.

STR. # 13

MILE 2
MILE 3

S18°-13'-19"W 820'± 595'± 627'± 75.00' 74'±

℄ R.R. TRACKS

P.I. STA. 112+00

EDGE OF R.O.W.

US RTE. 1

0.7 ± ACRES

KENRICK M. NORTON & NELLIE J. COLBY
PROB # 38509 3/1/53
(DESC. 537/224 (1) 8/25/1893)

EDGE OF R.O.W. S61°W

STA. 111+00

BUFFER STRIP

PROPOSED R.O.W.

N17°-41'-07"E 127.27' N17°-41'-07"E PROPOSED R.O.W. S48°27'E

S17°-41'-07"W 617.75'

EXETER & HAMPTON ELECTRIC Co.

EDGE OF R.O.W.

WALLACE A. SHAW
45612

WALLA

1450/32

STR. #16

842.14'

1171.88' N 58°-32'-21"W

856.01'

85.00' 50.5

50.78' S36°-57'-06"W

863.01' N 58°-32'-21"W

874.80'

85.39'

85.00'

1277.57' S 58°-32'-21"E

3.310 ACRES

215 SQ.FT.
(BOSTON & MAINE RAILROAD CORP.)

WALLACE A. SHAW & E. JANET
1450/328
11/5/5

EAA 11425

N.H.H.B.(FND.)

STR. #18

STATE OF N.H.

P.I. STA. 117+48.27 BACK = 117+46.83 AHEAD
= R.R. STA. 2419+73.66

STA. 118+00

STA. 121+50

SEE DETAIL (AT LEFT)

BUFFER STRIP

110'± TAN

105' DE
SINGLE POLE

110'±

P.I. ST
STR

EXISTI
NEW A
COUNT

S41° 3
37.

50'±

N17°-41'-07"E 193'±

S18°-13'-19"W

℄ R.R. TRACKS

P.I. STA. 112+00

DRILL HOLE (SET)

S64°-32'-05"W 76.50'

IRON PIPE (FND.)

N17°-41'-07"E ℄ PROPOSED R.O.W.

N64°-57'-05"E 123.35'

DRILL HOLE (SET) 14.80' W 33.00'

114.47'

718'±

522'±

S17°-41'-07"W

45.74'

S64°-57'-05"E 3.26'

DRILL HOLE (SET) 96.06'

138.13'

37.05'

N64°-57'-05"W

66.00'

101.94'

87.52'

55.00'

66.48'

29.56'

63.16'

69.97'

7.42'

207.20'

78.03'

U.S. RTE. 1

R.O.W.

EDGE OF

E. & H. E. Co. SUBSTATION

20'

LAFAYETTE ROAD

161.14'

STATE OF N.H.

N 58°-32'-21"W 178.32'

120.31'

N 17°-41'-07" E 61.78'

STA. 114+00

BUFFER STRIP

0.7± ACRE 9/7/62
1641/224

EDGE OF R.O.W.

EDGE OF R.O.W.

120' TAN

DETAIL - NOT TO SCALE

6/12/81	HRM		
6/11/81	DGP	DJH	DJH
8/30/78	B.J.	W.S.	T.M.
8/25/78	B.J.	W.W.	T.M.
DATE	DRWN.	CHKD.	APPR.
REVISIONS			

HAMPTO

LEGEND
EXISTING ACCESS ROAD
NEW ACCESS ROAD
COUNTERPOISE

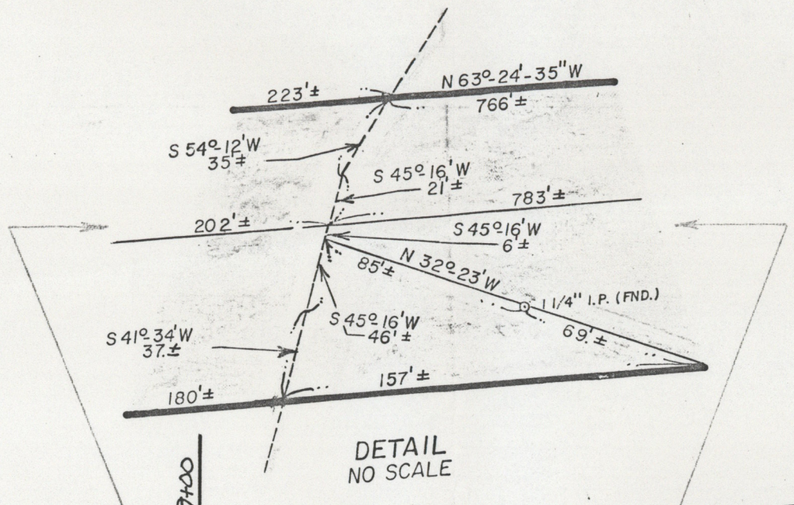

DETAIL
NO SCALE

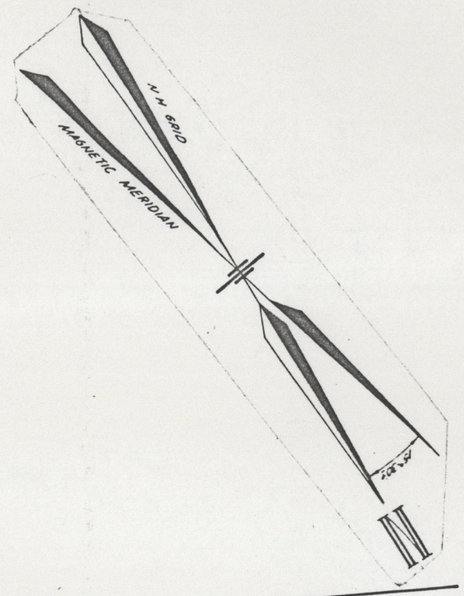

NOTE: CONTINUOUS COUNTER
OF-WAY IS LOCATED APPRO
CENTERLINE EXCEPT AS SH
BREAKS ONLY AT WATERC
ALL H. TANGENT STRUCTUR
BRUCE LAKE CO.

LEAVE A BUFFER OF VEGETAT
BETWEEN THE 33 KV. AND THE

LEAVE ALL LOW VEG
IN AND AROUND SWAMP

STA. 129+00

ROGER & ELISABETH B. HAMMOND
PROBATE # 48547
3/6/68
EAA 11327
2.3± ACRES

EAA 11425
WALLACE A. & E. JANET SHAW
1450/328
11/5/57

GFA-78
TOWN OF HAMPTON
1.1± ACRES

GFA
GFA
HO

STR. #19

EXETER & HAMPTON ELECTRIC CO.
EDGE OF R.O.W.
WALLACE A. SHAW
45612
1450/328
11/5/57
STR. #16
WEBSTER RUN
℄ OF MOST NORTHERLY POLE LINE
STA. 139+00
DRAKES RIVER
STA. 142+00
DITCH
DITCH
842.14'
EXISTING EXETER & HAMPTON R.O.W.
100.00'
N 63°-24'-3
N 63°-24'-3
S 63°-24'-3
1171.88'
N 58°-32'-21"W
856.01'
85.00'
50.54'
766'±
783'±
594'±
223'±
202'±
180'±
50.54'
1 1/4" I.P. (FND.)
863.01'
N 58°-32'-21"W
874.80'
85.00'
S 36°-37'-06"W
50.78'
85.39'
1277.57'
S 58°-32'-21"E
U.S. RTE. 1
LAFAYETTE ROAD
N.H.H.B. (FND.)
3.310 ACRES
215 SQ. FT.
(BOSTON & MAINE RAILROAD CORP.)
WALLACE A. SHAW & E. JANET SHAW
1450/328
11/5/57
EAA 11425
SEE DETAIL (AT LEFT)
BUFFER STRIP
STA. 118+00
STA. 121+50
105' DE
SINGLE POLES
110' E
P.I. STA. 129+70.25
STR. #17
0.1± ACRES
LILLIAN D. DREW
PROBATE # 44202 10/12/60
EAA 11347
N33°20'E
51'±
214'±
240'±
54'±
55'±
140'±
140'±
92'±
141'±
91'±
68'±
332'±
N 43°-47'E
N 89°-10'E
43'±
374'±
355'±
322'±
50.56'
N 25°-09'-25"E
85.03'
171.19'
3.847 ACRES
1/2"x12" I.P. (FND.)
DRAKESIDE
306.4'
N 59°-33'E
TIE COURSE
STR. #18
1.0± ACRES
EAA 11331
IRVING CAMPBELL
PROBATE # 39253 4/9/54
0.4± ACRES
EAA 11341
ROGER M. JAMES ESTATE
PROBATE # 52918 8/2/76
105°-14'

THOMAS F. MORAN INC.
surveyors
civil engineers
land planners
55 South River Road (Rt. 3)
Bedford, N.H. 03102
13 Nashua Street
Milford, N.H. 03055

THIS PLAN FOR RE
NO REPRESENTATION
MADE AS TO LOCATIO
OR OTHER POINTS

HAMPTON, N.H.

THIS PLAN FOR REFERENCE ONLY
NO REPRESENTATION OR WARRANTY IS
MADE AS TO LOCATION OF BOUNDARIES
OR OTHER POINTS OF REFERENCE.

NOTE: CONTINUOUS COUNTERPOISE ALONG RAILROAD RIGHT-OF-WAY IS LOCATED APPROXIMATELY 10 FEET LEFT OF THE CENTERLINE EXCEPT AS SPECIFICALLY NOTED ON PLAN AND BREAKS ONLY AT WATERCROSSINGS WHERE BRIDGES EXIST. ALL HF TANGENT STRUCTURES ARE STEEL MANUFACTURED BY BRUCE LAKE Co.

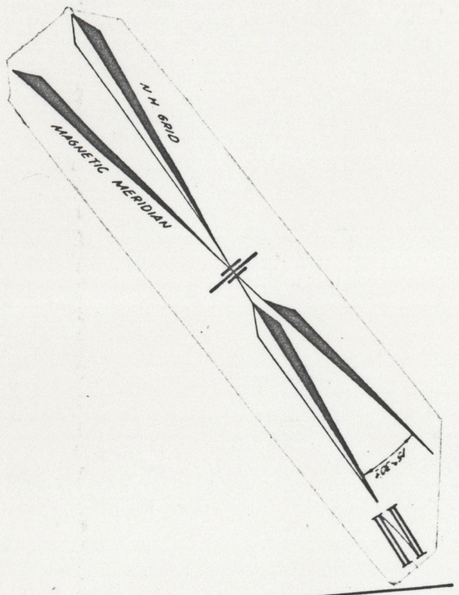

LEAVE A BUFFER OF VEGETATION 10'-15' WIDE BETWEEN THE 33 KV. AND THE 345 KV. TRANS. LINES.

LEAVE ALL LOW VEG IN AND AROUND SWAMP

ELISABETH B. MMOND 48547 3/6/68 11327 3± ACRES

STA. 139+00

DRAKES RIVER

STA. 142+00

GFA-78
TOWN OF HAMPTON
1.1± ACRES

STR. #19

GFA 73 BOOK 2367
GFA 72 PAGE 16
HOWARD D. JR. & LOIS A.
PAGE
2297/669 10/19/77

STR. #20

MILE 3
MILE 4

D.H. (SET)
N 05° 54'-05"E
207.78'

P.I. TO P.I. 3595.52'

DITCH

N 63°-24'-35" W 1212.53'

54.03'
32.12'
D.H. (SET)
58.86'
N 05° 36'-52"E
138.94'

3579.83' P.I. TO P.I.

PTON R.O.W. 100.00'

N 63°-24'-35" W 1230.36'

N 33° 20' E 51'±
214'±
240'±
54'±
140'±
55'±
374'±
50.56'
N 25° 05'-25" E
85.03'
355'±
140'±
S 50° 48'-56" W
92'±
141'±
322'±
N 43° 47' E 68'±
91'±
332'±
N 89° 10' E 43'±

1260.64'

3570.51' P.I. TO P.I.

80.08'
D.H. (SET)
D.H. (FND.)
N 03° 41'-17"E
29.92'
N 05° 14'-56"E
206.37'

S 63°-24'-35" E

3.847 ACRES

1/2"x12" I.P. (FND.)

DRAKESIDE ROAD

NAIL (FND.) IN FENCE POST

THOMAS F. MORAN No. 2
THE STATE OF NEW HAMPSHIRE
REGISTERED LAND SURVEYOR

1.0± ACRES
EAA 11331
IRVING CAMPBELL
PROBATE # 39253 -4/9/54

STR. #18

306'± N 59° 33' E TIE COURSE

0.4± ACRES EAA 11341
ROGER M. JAMES ESTATE
PROBATE # 52918 8/2/76

THOMAS F. MORAN INC.
surveyors
civil engineers
land planners
th River Road (Rt. 3)
ord, N.H. 03103
13 Nashua Street
Milford, N.H. 03055

THIS PLAN FOR REFERENCE ONLY.
NO REPRESENTATION OR WARRANTY IS
MADE AS TO LOCATION OF BOUNDARIES
OR OTHER POINTS OF REFERENCE.

SEABROOK TO NEWINGTON

345 KV. TRANSMISSION LINE

MILE #3

PUBLIC SERVICE CO. OF NEW HAMPSHIRE
ENGINEERING DEPARTMENT
SCALE VERT. 1"= 20' HOR. 1"=200' DATE 4-18-78

LINE # 369